


# MORTGAGE PLOT PLAN


RICHARD P. MILLETTE AND ASSOCIATES  
501 ISLINGTON STREET  
P.O. BOX 4006  
PORTSMOUTH, NEW HAMPSHIRE 03801  
TELEPHONE: (603) 431-2222

JOB No.: 8714-2  
JOB NAME: LANDMARK BUILDERS INC.  
JOB LOCATION: GOSS ROAD, NORTH HAMPTON,  
NEW HAMPSHIRE  
DEED REFERENCE:  
PLAN REFERENCE: RCRD PLAN # D- 16404


NOTE: THE PARCEL SHOWN HEREON IS PRODUCED BASED ON EXISTING SURVEY CONTROL AT THE SITE. THIS PLOT PLAN DOES NOT VERIFY THE CORRECTNESS OF THE SAME.

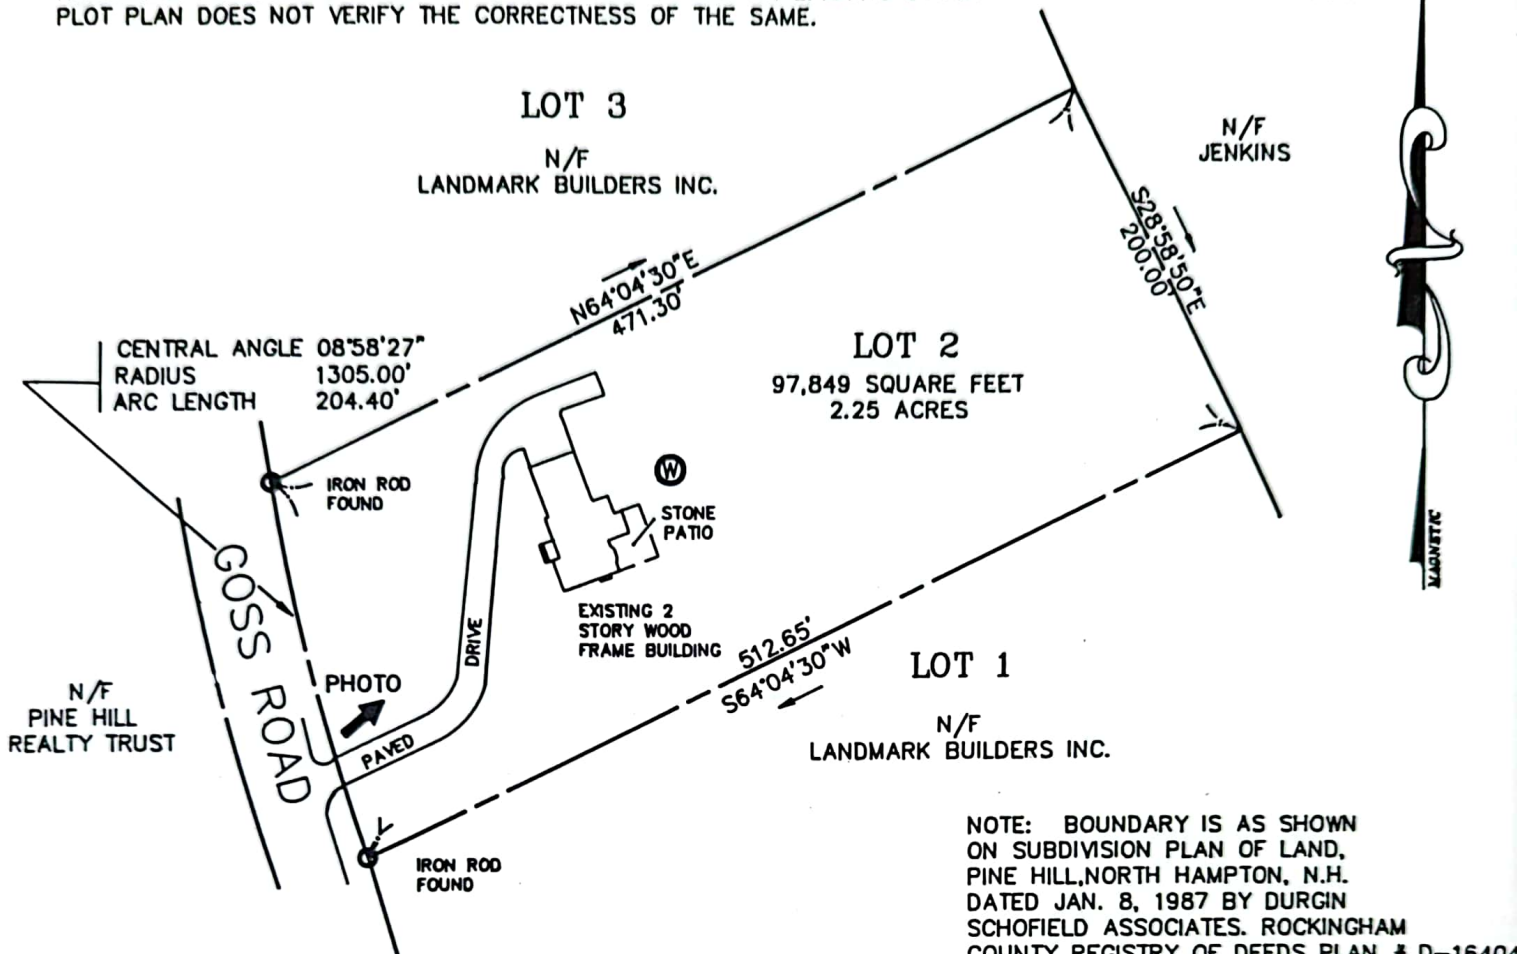


SCALE: 1"=100'

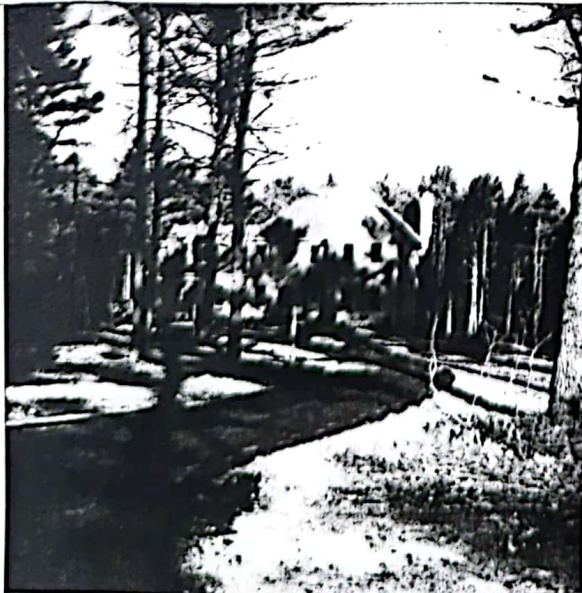

I CERTIFY THIS PLAN SHOWS IMPROVEMENTS LOCATED ON THE PROPERTY; THAT THESE IMPROVEMENTS CONFORM WITH LOCAL ZONING ORDINANCES, WHERE APPLICABLE; THE PROPERTY IS NOT IN A FLOOD HAZARD ZONE AS DEFINED BY US DEPT. OF HOUSING & URBAN DEVELOPMENT. THIS PLAN IS PRODUCED FOR MORTGAGE PURPOSES ONLY AND IS NOT A PERIMETER SURVEY.

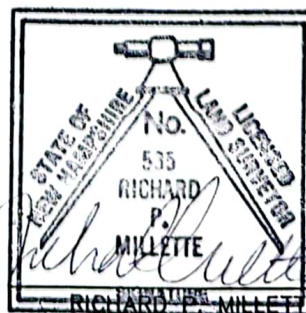

12-28-90  
DATE

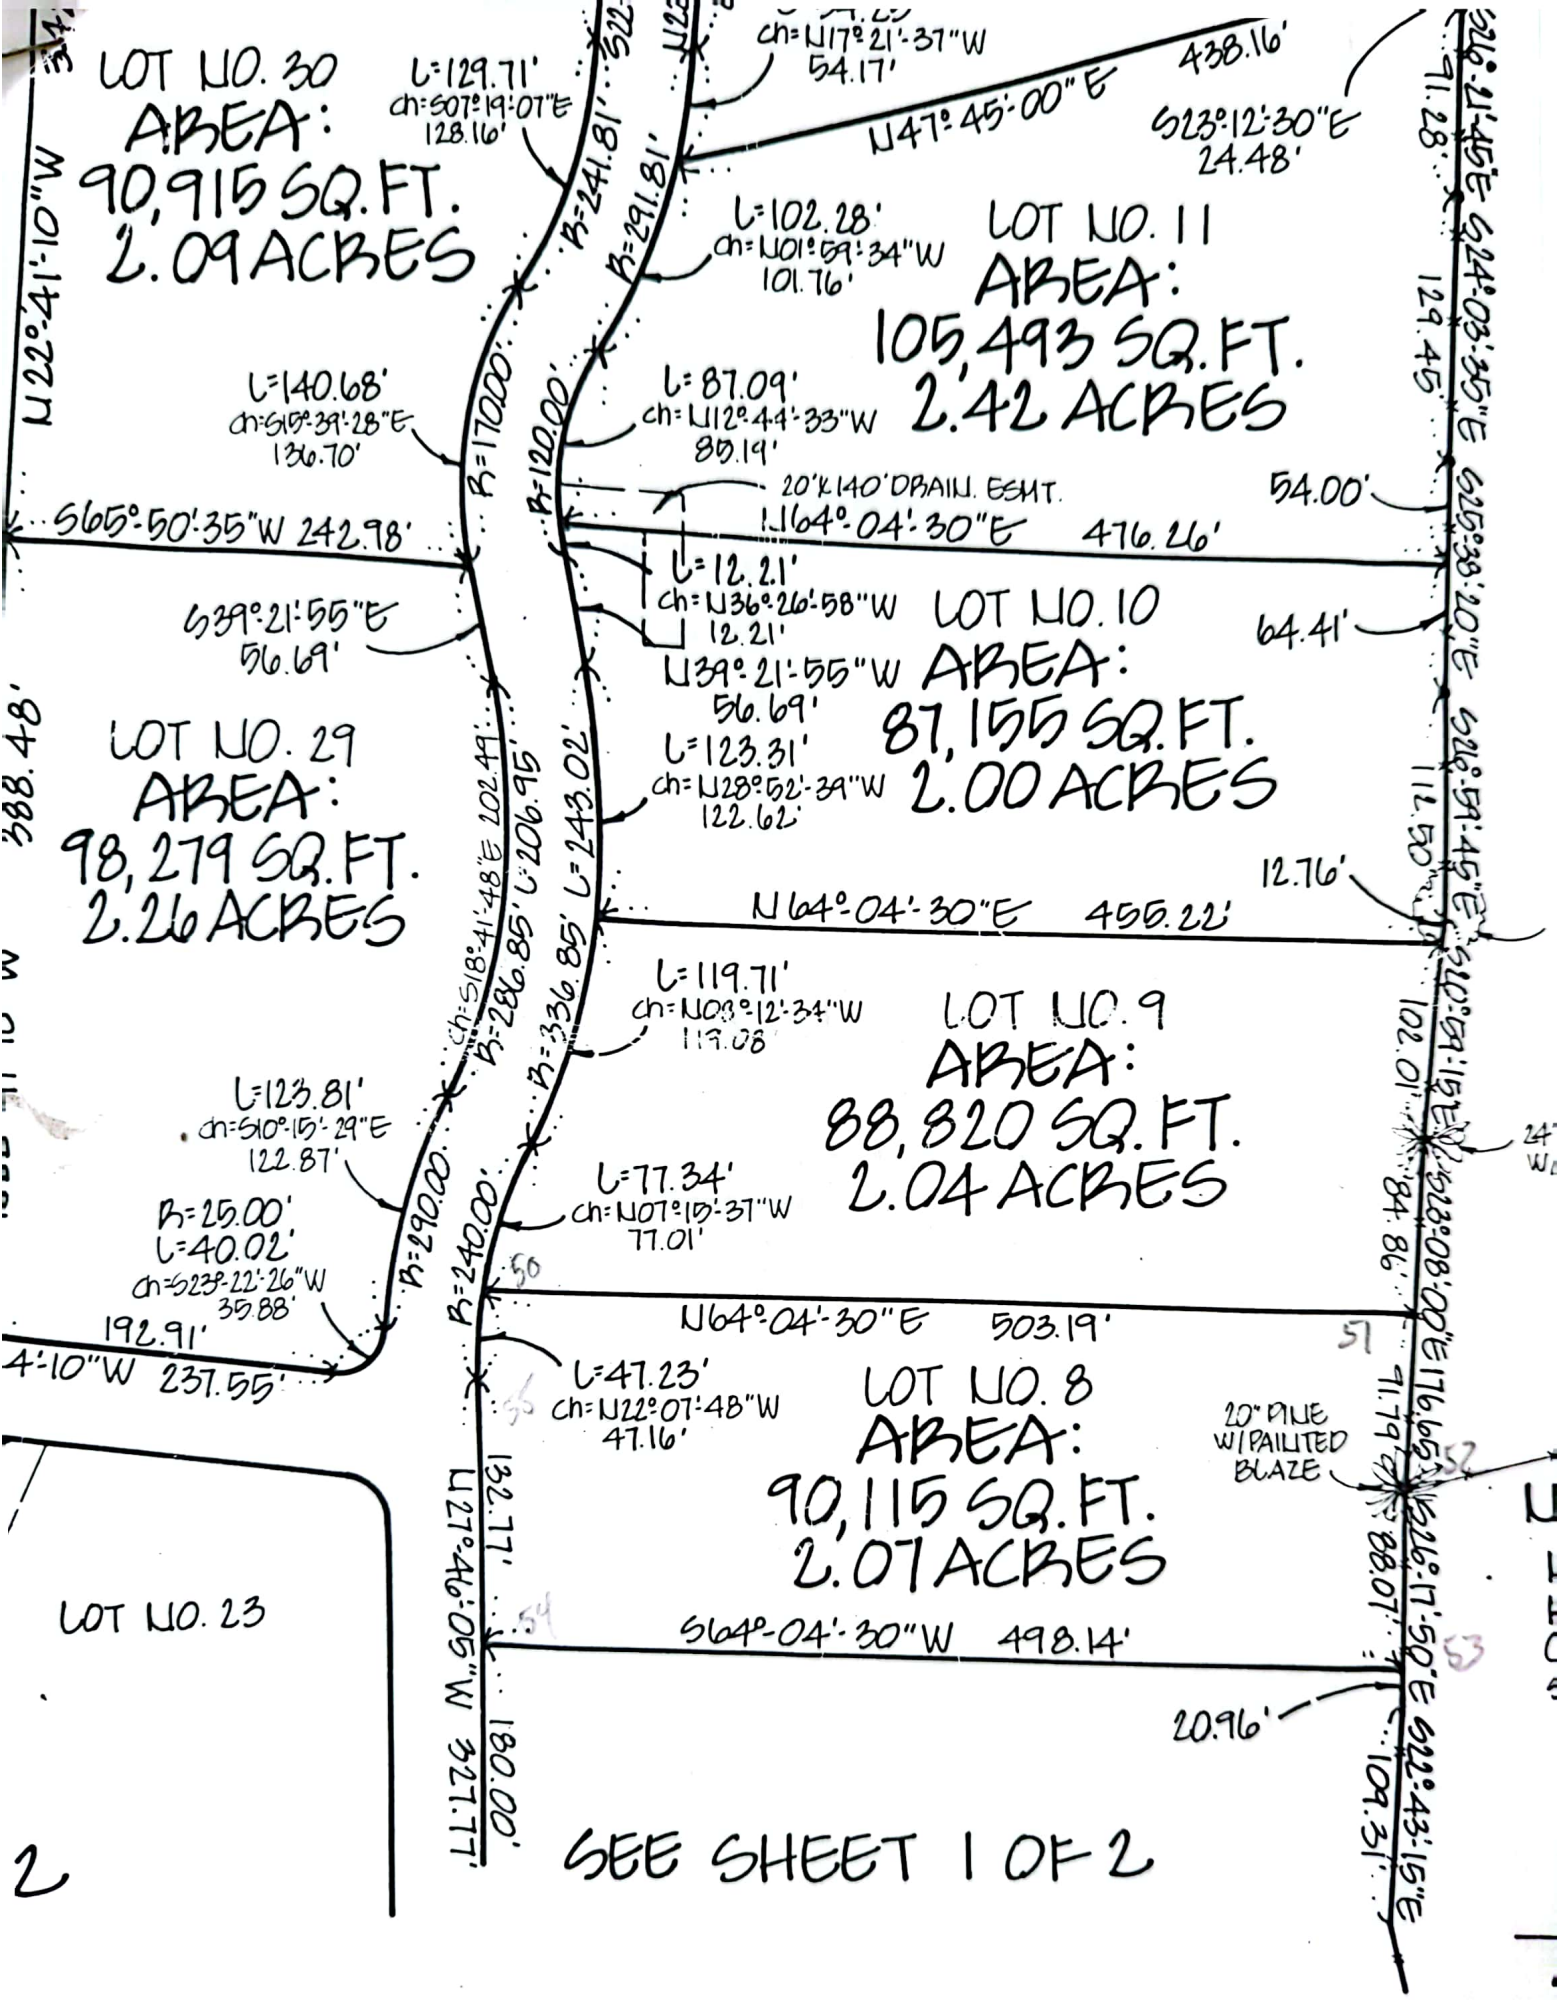

2

SEE SHEET 1 OF 2



54	4618.8512	4627.0685	TRA
55	4736.3315	4565.2118	TRA
56	4732.6261	4563.7050	TRA

Point#, Start#-End# or G# = 1-6310-  
 Command = 10-  
 Occupied Point = 20

20	4819.0097	4627.6532	OCC
----	-----------	-----------	-----

Backsight Point = 2-  
 Command = 210-

Point#, Start#-End# or G# = 1-63

<del>106.72</del>	TOPSTK	1	5000.1211	4999.2343	
106.72	GND	2	4805.2242	4652.0820	TRA
105.66	GND	3	4842.7665	4759.3310	SS
107.14	TOPSTK	4	4778.1909	4740.8781	SS
104.92	PIT#2	5	4760.6981	4770.6255	SS
104.82	GND	6	4730.4865	4788.8655	SS
104.69	GND	7	4689.6015	4834.7789	SS
104.63	GND	8	4712.4273	4798.1234	SS
104.92	GND	9	4881.5311	4732.6662	SS
105.74	GND	10	4852.6197	4757.3329	SS
106.14	GND	11	4843.6106	4722.2139	SS
106.97	GND	12	4881.9381	4720.9181	SS
106.73	GND	13	4821.3057	4685.4044	SS
107.99	GND	14	4919.9445	4677.3031	SS
107.93	GND	15	4871.9747	4666.6891	SS
108.10	GND	16	4859.4824	4613.0824	SS
108.07	GND	17	4883.1921	4590.1048	SS
108.14	GND	18	4858.2017	4568.0473	SS
107.81	GND	19	4842.6285	4600.5820	SS
106.77	PIT#1	20	4819.0097	4627.6532	SS
108.43	GND	21	4805.2947	4586.6020	SS
108.88	GND	22	4807.7166	4562.0264	SS
109.67	TOPIPIN	23	4780.0082	4547.4475	SS
107.77	GND	24	4789.6384	4589.5552	SS
107.29	RIMCB	25	4694.0707	4580.4049	SS
109.15	GND	26	4728.8166	4578.2659	SS
107.79	BS	27	4754.5766	4603.5305	SS
107.55	FILL1	28	4741.7086	4630.2593	SS
107.68	FILL2	29	4780.5110	4641.8437	SS
106.86	FILL3	30	4792.5208	4672.3499	SS
106.83	FILL4	31	4768.3102	4681.9116	SS
106.42	FILL5	32	4748.2048	4705.2472	SS
106.30	FILL6	33	4724.3725	4716.8101	SS
105.76	FILL7	34	4694.9639	4699.0318	SS
106.64	FILL8	35	4674.3829	4686.3723	SS
106.40	FILL9	36	4657.4117	4663.7208	SS
106.49	OG	37	4659.4551	4692.8028	SS
106.51	OG	38	4651.2816	4646.8952	SS
107.54	GND	39	4710.9747	4653.4862	SS
107.30	EDGPILE	40	4716.3523	4672.1975	SS
107.67	TOPIPIN	41	4618.8773	4627.0552	SS
107.98	EP	42	4630.6708	4603.9045	SS
108.57	EP	43	4663.0274	4586.8148	SS
109.30	EP	44	4715.2433	4559.9671	SS
<del>105.30</del>		45	5000.4149	4999.7575	TRA
<del>101.47</del>		46	4999.8045	5000.1001	TRA
		47	4818.9997	4627.6581	INT
		50	4780.0082	4547.4475	TRA
		51	5000.0000	5000.0000	TRA
		52	4915.5906	5036.0617	TRA
		53	4836.6351	5075.0792	TRA
		54	4618.8512	4627.0685	TRA
		55	4736.3315	4565.2118	TRA
		56	4732.6261	4563.7050	TRA

Point#, Start#-End# or G# = 130-



# APPROVAL FOR CONSTRUCTION

N.H. DEPARTMENT OF ENVIRONMENTAL SERVICES  
WATER SUPPLY & POLLUTION CONTROL DIVISION  
P.O. BOX 95, 6 HAZEN DRIVE, CONCORD, NH 03302-0095

ANS AND SPECIFICATIONS FOR SEWAGE OR WASTE DISPOSAL SYSTEM SUBMITTED FOR:

ER:

LANDMARK BLDG. 861 LAFAYETTE ROAD HAMPTON, NH 03842

SENT TO: BUILDING INSPECTOR  
PO BOX 710  
NORTH HAMPTON, NH 03862

Lot Numbers: 23476  
Subd. Appvl. No.: PINE HILL  
Subd. Name:

Type of System: 000000004BR  
000600GPD

Town/City Location: NORTH HAMPTON

Street Location: LOT 8 GOSS ROAD

PLICANT: PERMIT NO. 0000000348


STOCKTON SERVICES  
PO BOX 1306  
HAMPTON, NH, 03842

Subsurface waste disposal systems must be operated and maintained in a manner so as to prevent nuisance or health hazard due to system failure. (RSA 485-A:37)

It is unlawful to discharge any hazardous chemicals or substances into subsurface waste disposal systems. Included are paints, thinners, gasoline and chlorinated hydrocarbon solvents such as TCE, sometimes used to clean failed septic systems and auto parts. (Env-Ws 410.05)

ADVISE YOUR CONTRACTOR OF REQUIRED CHANGES  
IN PLANS AS INDICATED BELOW CONDITIONS

LOAM AND SEED COMPLETED SYSTEM. USE 3" FILL EXTENSIONS.

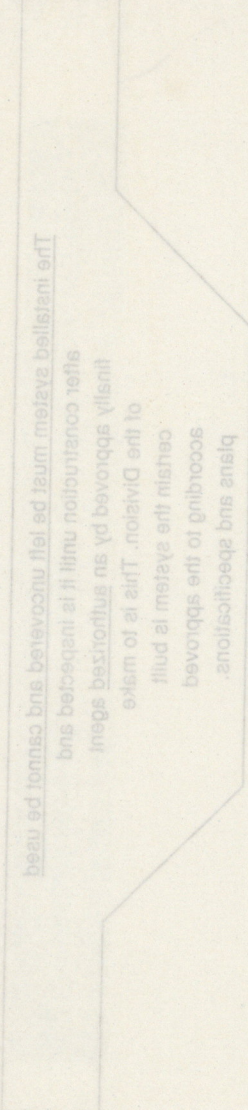

RUO RO 301FO JANOIOR ,1038-ITS :EOICFO 2IHT TOATNO  
NOITCOCNOI FOR YDAER MEHW ,THEGA JAOO CEEIRHTUA

Approved this date: 04/24/91  
Date amended: 04/24/91  
By: [Signature]  
N.H. Water Supply & Pollution Control Division Staff  
Amended by: [Signature]  
(OVER)

APPLICANT'S

## PERC TEST

DATE: 4/11/91

DEPTH OF HOLE: 10"

RATE OF PERC: 5 MIN/IN

DESIGN LOADING: 4 BEDROOMS

AREA REQUIRED: 862.5 SQ. FT.

PROPOSED SYSTEM: 25' x 35' FOR

875 SQ. FT. AREA PROVIDED

## PLAN OF PROPOSED SEPTIC SYSTEM

LOCUS: LOT 8 GOSS ROAD  
NORTH HAMPTON, NH

OWNER: LANDMARK BUILDERS  
861 LAFAYETTE RD  
HAMPTON, NH, 03842

APPLICANT: ANNE W. BIALOBRZESKA  
247 LANDING ROAD  
HAMPTON, N.H. 03842  
DESIGNER PERMIT #348

DATE: 4/16/91

APPROVAL:

139

